


THE CLIFF CONSERVATION AREA BOUNDARY

This drawing is copyright to Urban Vision Partnership Limited. It shall not be used without permission for any purpose. Reproduction is only permitted by prior arrangement. Do not scale from this drawing. All discrepancies to be related back to the originator for verification prior to commencing the works. All dimensions are in millimetres unless otherwise stated.

 REVISED CONSERVATION AREA BOUNDARY

 EXTENSION TO PREVIOUS BOUNDARY OF CONSERVATION AREA

Based upon the current Ordnance Survey mapping with the permission of the Controller of Her Majesty's Stationery Office © Crown copyright. Unauthorised reproduction infringes Crown copyright & may lead to prosecution or civil proceedings. Salford City Council Licence no. 100019737 All copies of this drawing issued for use under contract are to be returned to the City of Salford on completion of the contract.

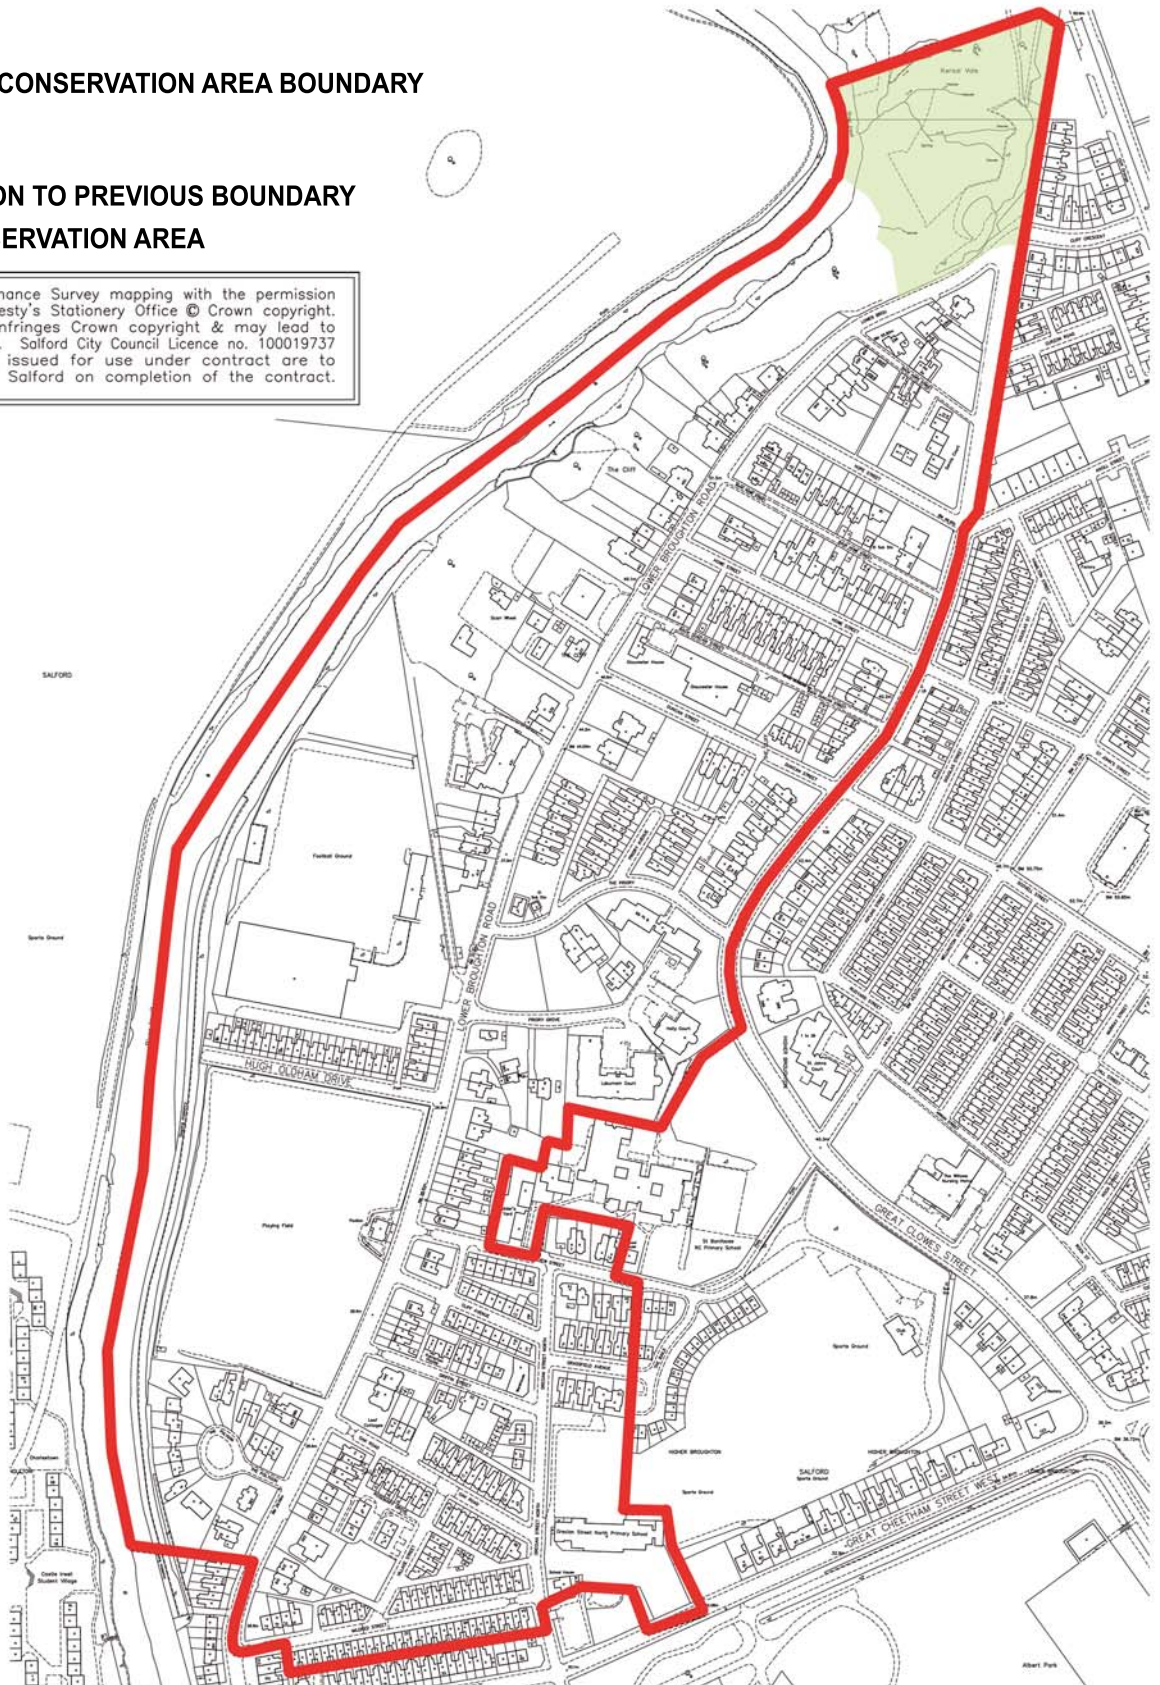

rev	description	date	drawn	chk



Urban Vision Partnership Limited
Emerson House Albert St Eccles Manchester M30 0TE T 0161 779 4800

Urban Vision Partnership Limited



client _____

project _____

THE CLIFF CONSERVATION AREA APPRAISAL

drawing _____

REVISED BOUNDARY

approval status _____ date

Feasibility / Sketch _____ MAY 2008

Design _____

Tender _____

Construction _____

As Built _____

project ref. _____ scale @ A4

drawing number _____

D11094

www.urbanvision.org.uk