

Based upon the current Ordnance Survey mapping with the permission of the Controller of Her Majesty's Stationary Office © Crown copyright. Unauthorised reproduction infringes Crown copyright & may lead to prosecution or civil proceedings. Salford City Council Licence no. 100019737 All copies of this drawing issued for use under contract are to be returned to the City of Salford on completion of the contract.


CRESCENT CONSERVATION AREA BOUNDARY



REVISED CONSERVATION AREA BOUNDARY



EXTENSION TO PREVIOUS CONSERVATION AREA BOUNDARY

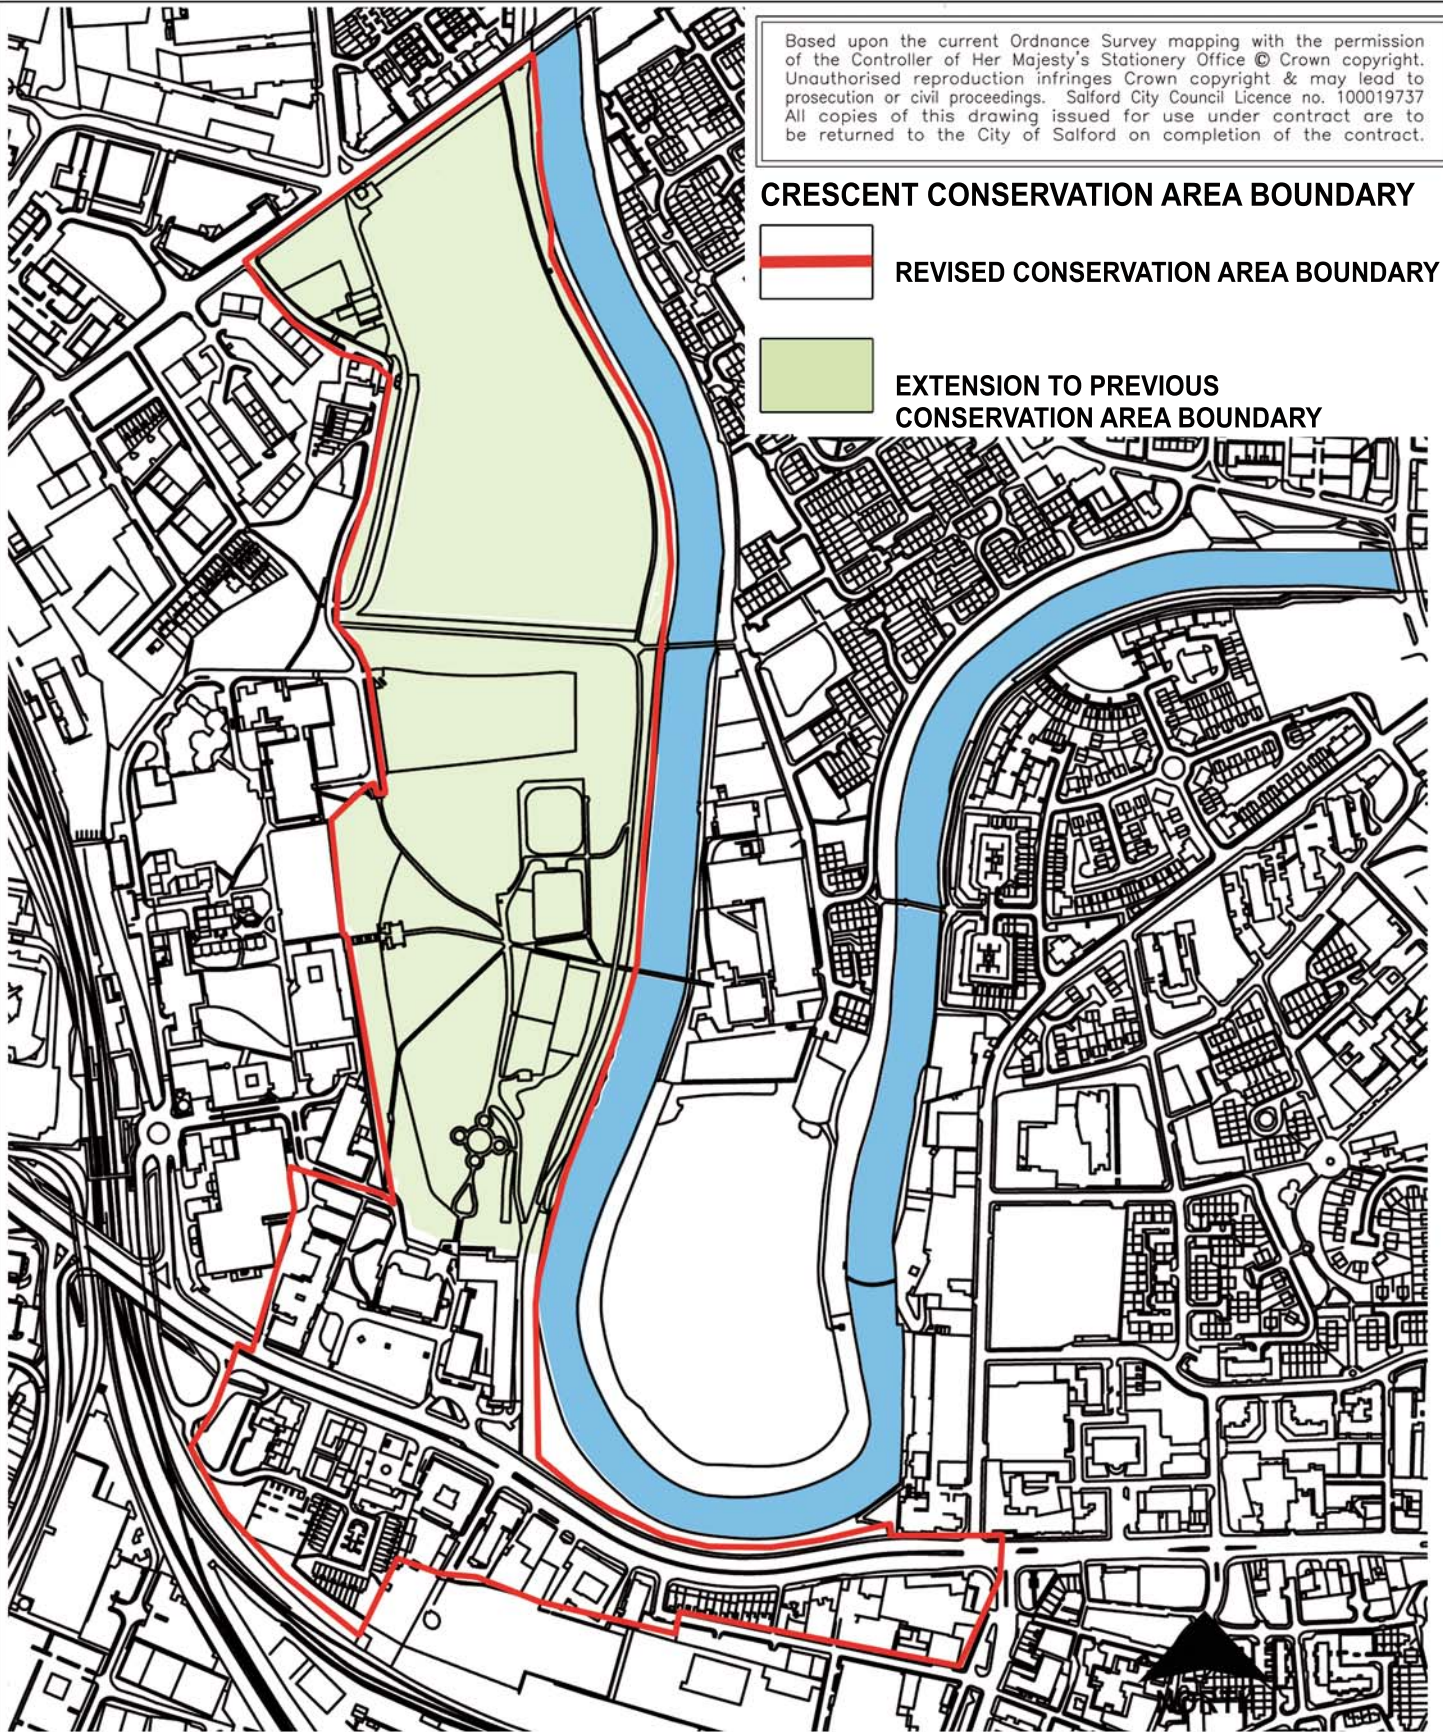

rev	description	date	drawn	chk



Urban Vision Partnership Limited
Emerson House Albert St Eccles Manchester M30 0TE T 0161 779 4800



client _____

project
CRESCENT CONSERVATION AREA APPRAISAL

drawing _____

REVISED BOUNDARY

approval status _____ date

Feasibility / Sketch _____ MAY 2008

Design _____ drawn

Tender _____ JH

Construction _____ checked

As Built _____ CLM

project ref. _____ scale @ A4

O11731 _____ NTS

drawing number _____ revision