

This drawing is copyright to Urban Vision Partnership Limited. It shall not be used without permission for any purpose. Reproduction is only permitted by prior arrangement. Do not scale from this drawing. All discrepancies to be related back to the originator for verification prior to commencing the works. All dimensions are in metres unless otherwise stated.

HEALTH AND SAFETY INFORMATION

Hazards, that would not have been foreseen by a reasonably competent contractor, have been identified by the designer.

rev	description	date	drawn	chk	app



Urban Vision Partnership Ltd, Emerson House, Albert Street, Eccles, Manchester, M30 0TE. T 0161 779 4800

client

project

Traffic Management Unit
Hackney Carriage Ranks

drawing

Rossal Way, Salford
Existing layout - 8 bays

approval status

- Feasibility / Sketch
- Design
- Tender
- Construction
- As Built

date

19/01/2010

drawn

checked

approved


project ref.

scale @ A4

drawing number

revision

hackney carriage ranks

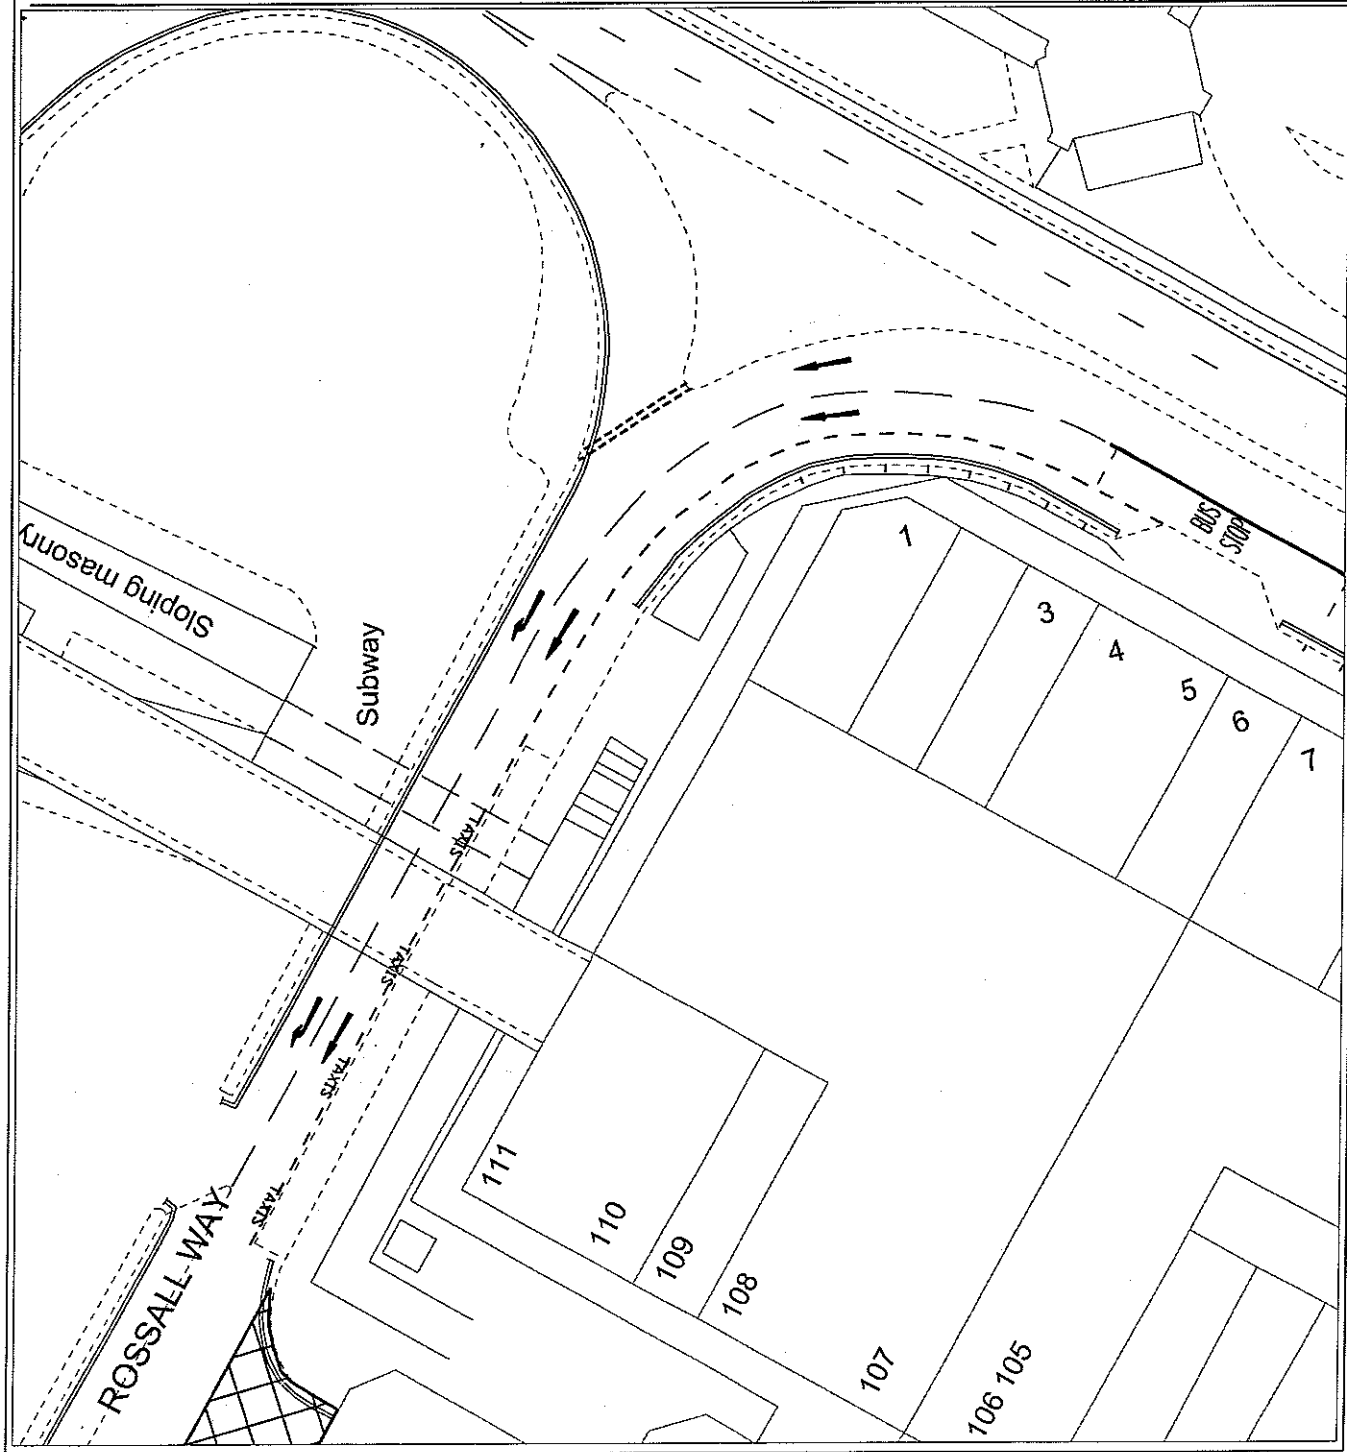

drawing location: Y:\Traffic Management\Traffic Management and Control\Acad_GILNBDWCS

This drawing is copyright to Urban Vision Partnership Limited. It shall not be used without permission for any purpose. Reproduction is only permitted by prior arrangement. Do not scale from this drawing. All discrepancies to be referred back to the originator for verification prior to commencing the works. All dimensions are in metres unless otherwise stated.

HEALTH AND SAFETY INFORMATION

Hazards, that would not have been foreseen by a reasonably competent contractor, have been identified by the designer.

rev	description	date	drawn	chk	app



Urban Vision Partnership Ltd, Emerson House, Albert Street, Eccles, Manchester, M30 0TE. T 0161 779 4800

client

project

Traffic Management Unit
Hackney Carriage Ranks

drawing

Rossal Way, Salford
Proposed Layout - 13 spaces

approval status	date
<input type="radio"/> Feasibility / Sketch	16/04/2010
<input type="radio"/> Design	drawn
<input type="radio"/> Tender	checked
<input type="radio"/> Construction	approved
<input type="radio"/> As Built	


project ref.

scale @ A4

drawing number

revision

hackney carriage ranks

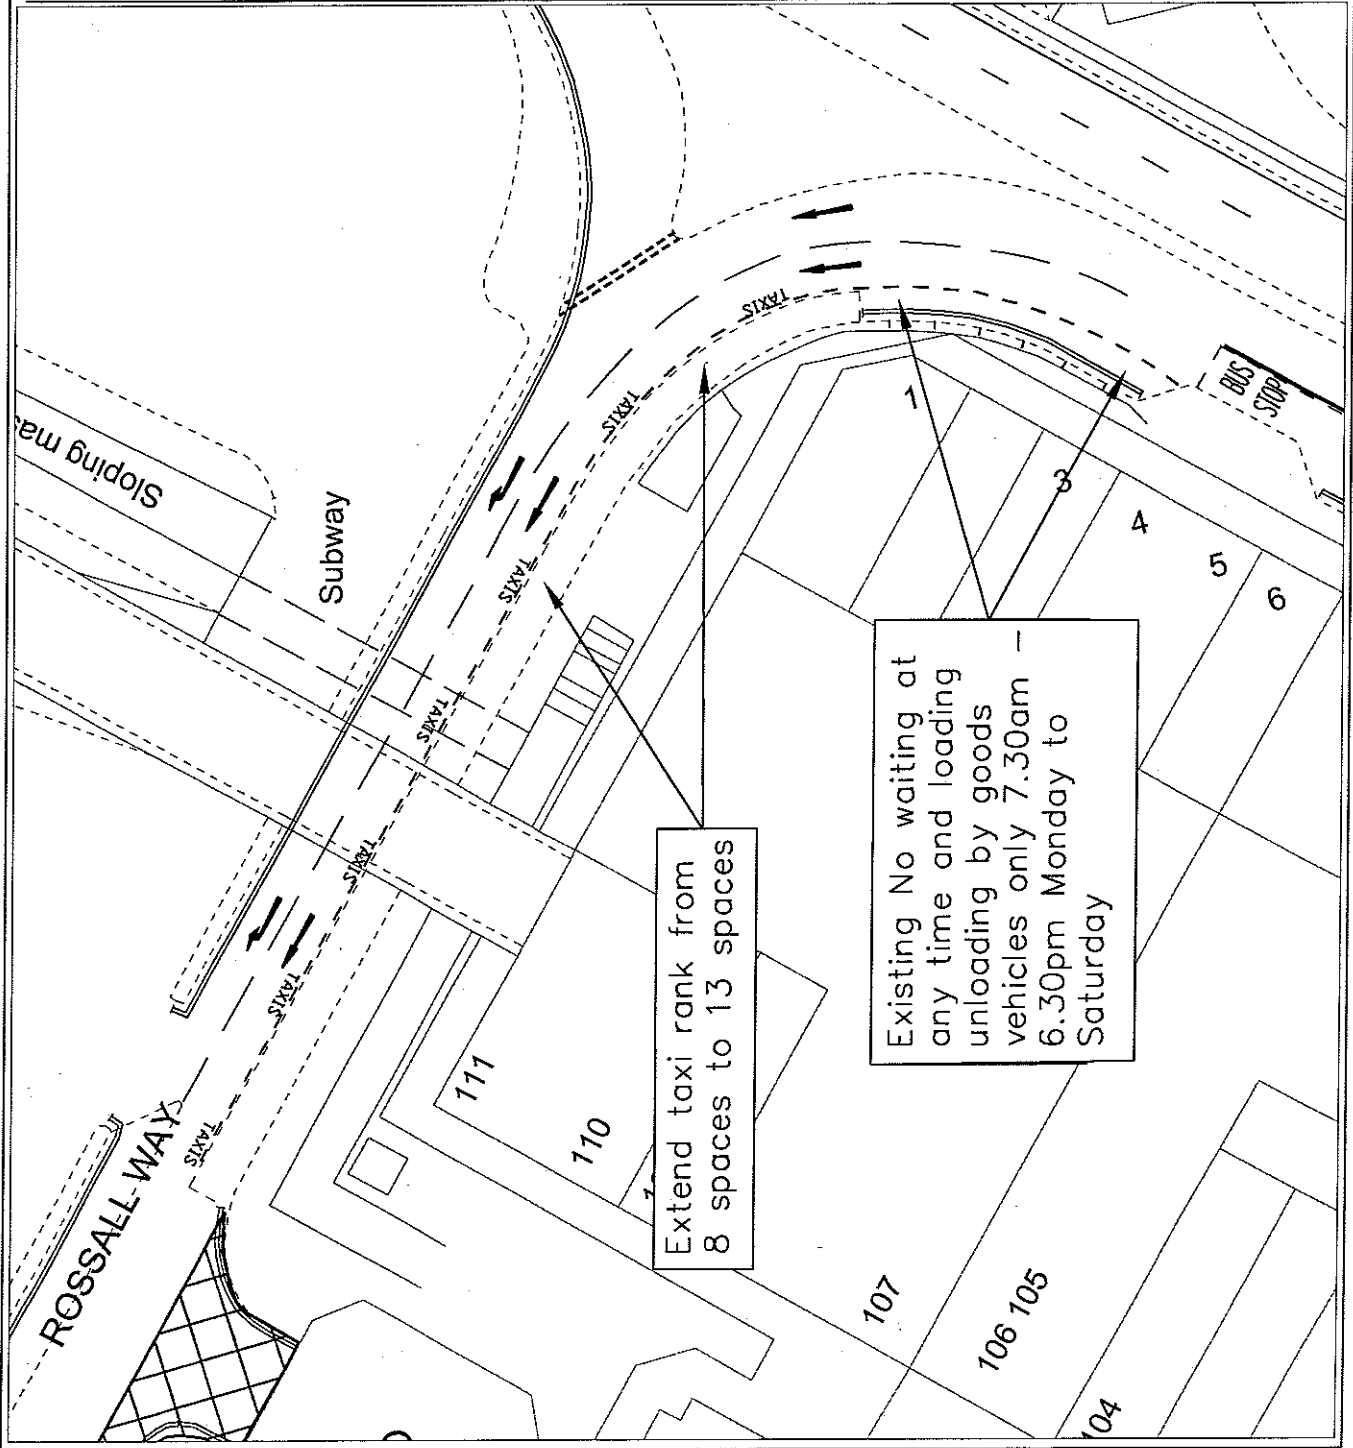

drawing location: Y:\Traffic Management\Traffic Management and Control\Acad\GILL\DWGS